


NOTES:  
1. DO NOT SCALE. USE FIGURED DIMENSIONS ONLY.  
2. THIS DRAWING IS TO BE READ IN CONJUNCTION WITH ALL  
OTHER RELEVANT ARCHITECTURAL AND ENGINEERING  
DRAWINGS.

**LEGEND**

	REDLINE BOUNDARY
	PROPOSED ROAD CHAINAGE
	PROPOSED ROAD LEVEL
	ROAD GRADIENT
	ROAD LOW POINT
	ROAD HIGH POINT
	PROPOSED FINISHED FLOOR LEVEL
	PROPOSED ROAD GULLY
	PROPOSED KERB INLET

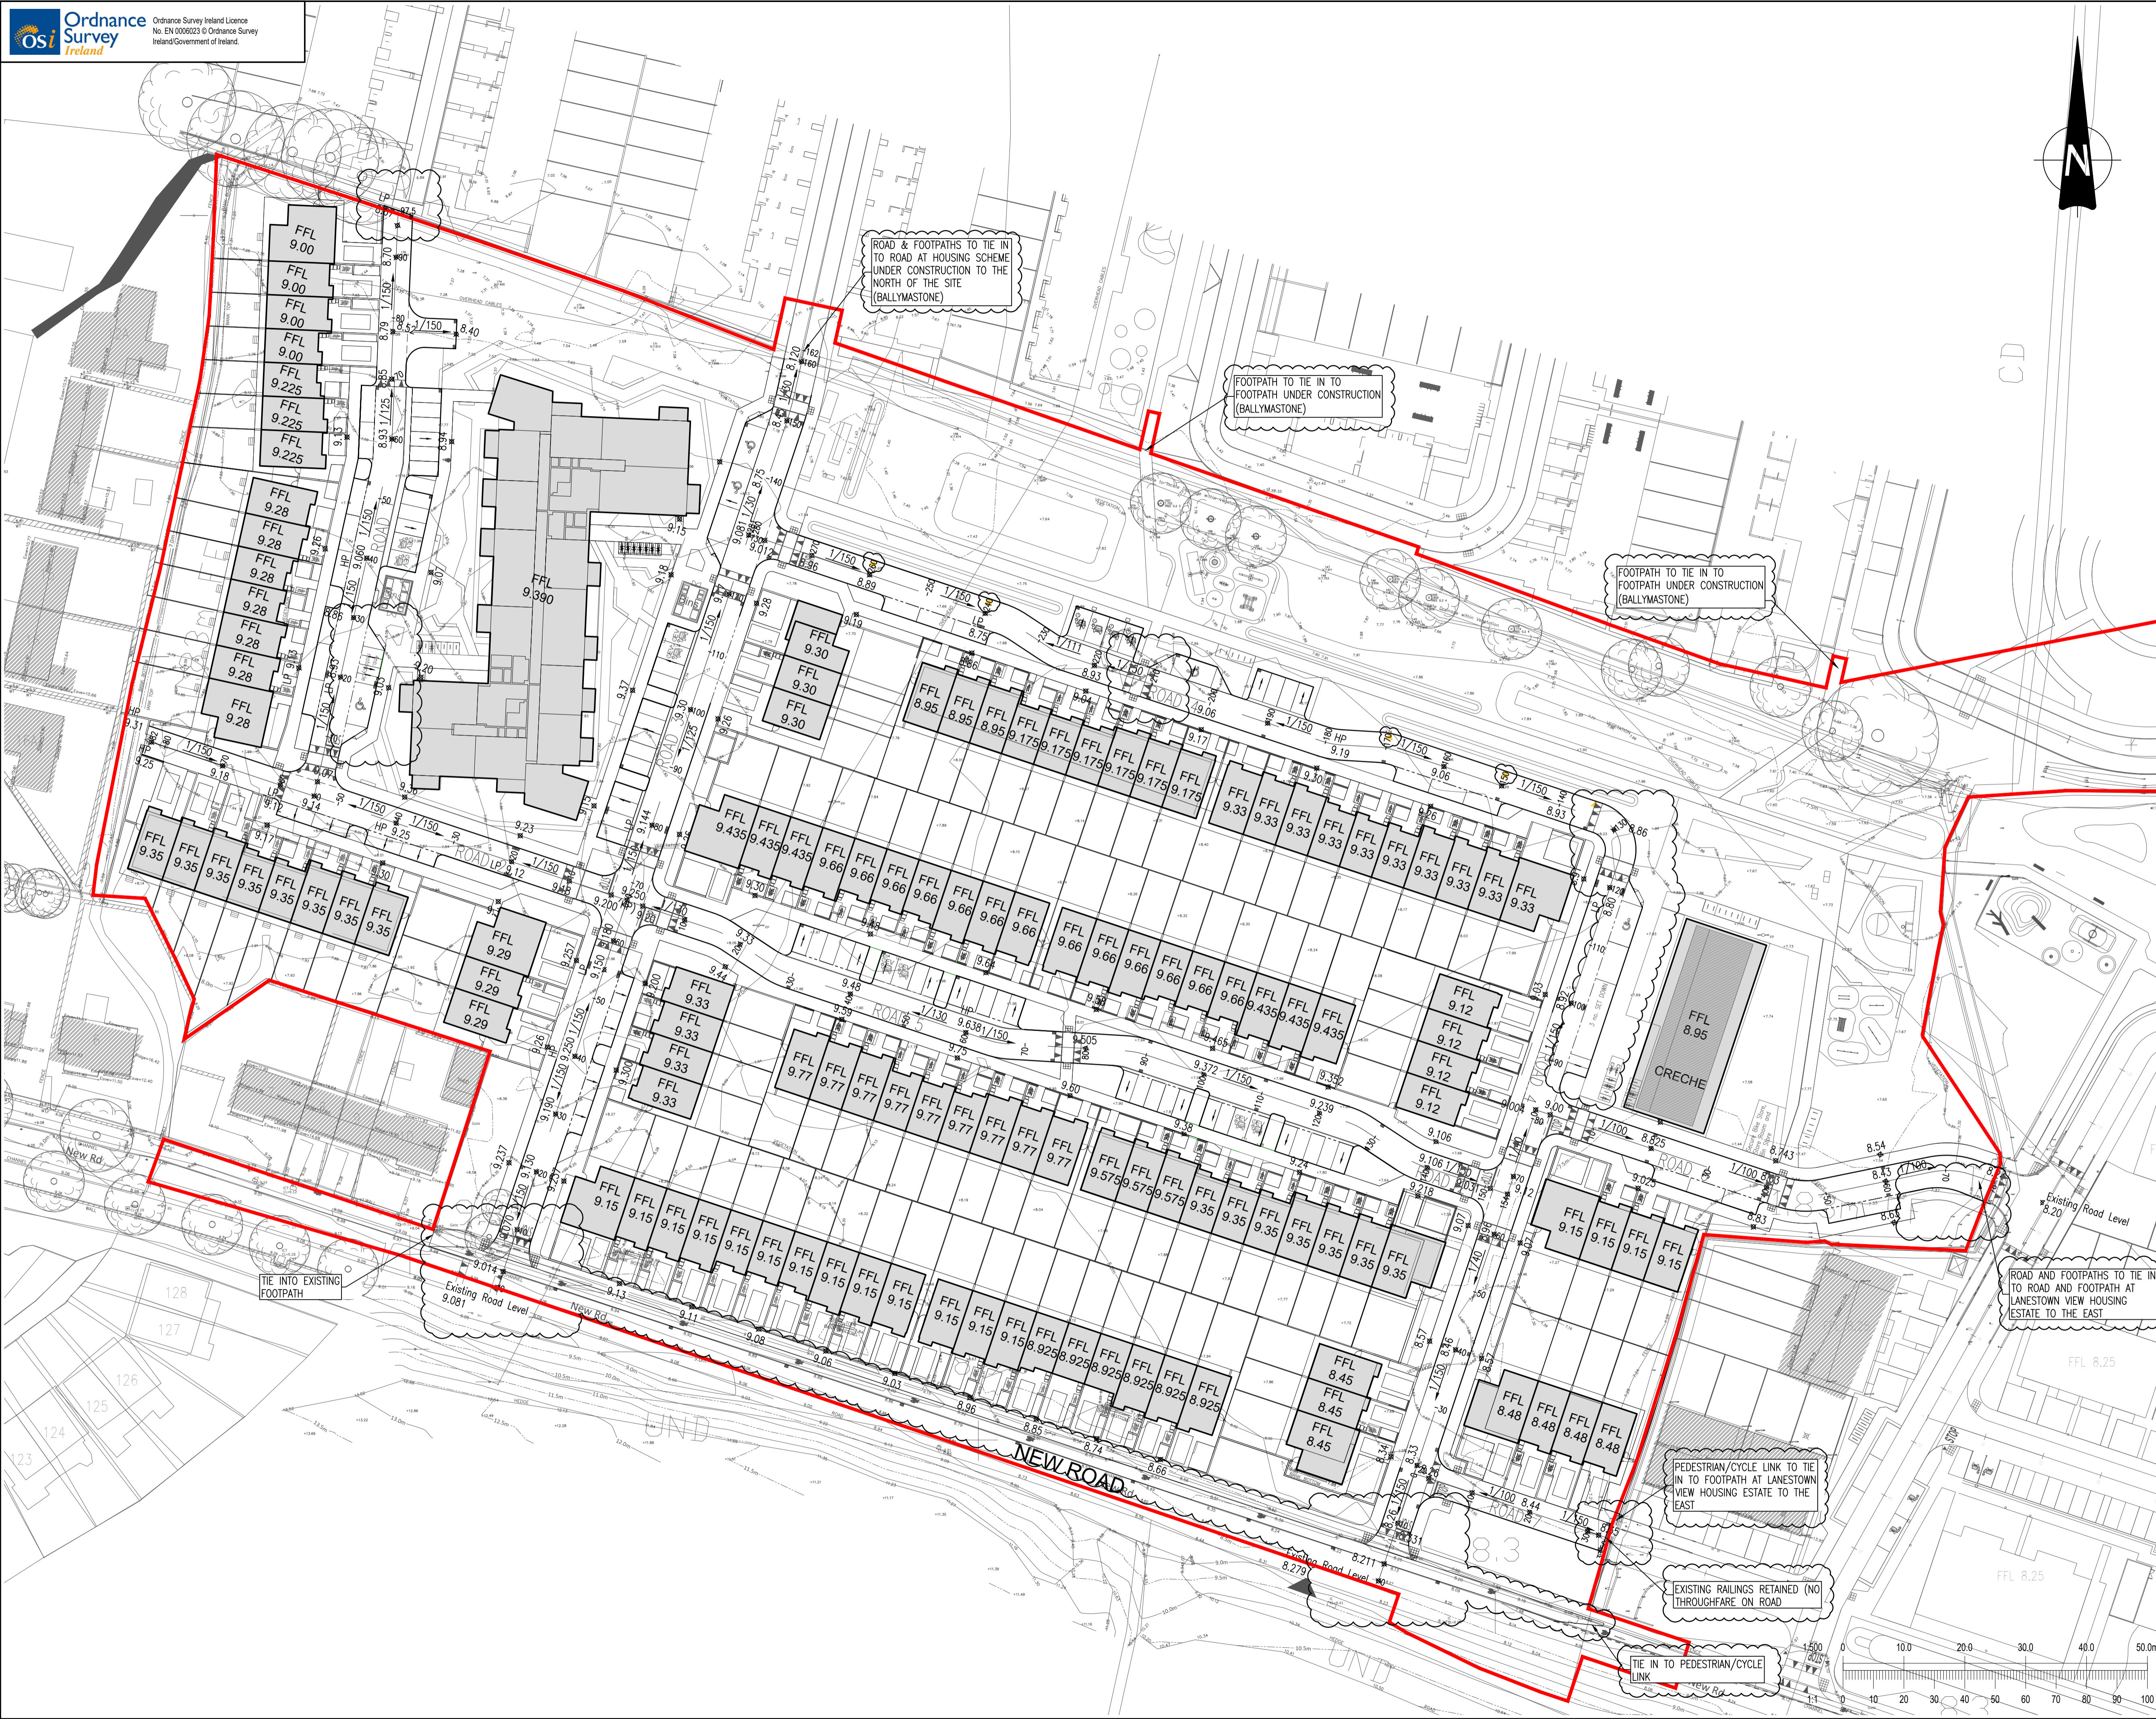

Rev	Date	Description	By	CHK
A	04/04/24	REVISED AS CLOUDED	PJD	MD

**PROPOSED RESIDENTIAL DEVELOPMENT  
NEW ROAD, DONABATE**

**PROPOSED ROAD LAYOUT & LEVELS**

FINGAL COUNTY COUNCIL



BLOCK S, EASTPOINT BUSINESS PARK, ALFIE BYRNE ROAD,  
DUBLIN D03 H3F4 IRELAND. Tel: (01) 864 8900  
Email: info@waterman-moylan.ie www.waterman-moylan.ie

**FOR PUBLIC DISPLAY**

Designed By	PJD	Approved	MD	Waterman Ref	23-129
Drawn By	PJD	Date	APRIL 2024	Scales @ A1	1:500
Project	Originator	Volume	Level	Type	Role
NRD-WMC-XX-00 - DR - C - P100					A