NOTES

1. THIS DRAWING IS TO BE READ IN CONJUNCTION WITH RELEVANT ARCHITECTS AND ENGINEERS DRAWINGS.
2. FIGURED DIMENSIONS ONLY TO BE TAKEN FROM THIS DRAWING. ALL DIMENSIONS TO BE CHECKED ON SITE. ENGINEER TO BE INFORMED IMMEDIATELY OF ANY DISCREPANCIES BEFORE ANY WORK PROCEEDS.
3. REFER TO DRAWING **21208-DOW-0009** FOR PROJECT SPECIFICATION.

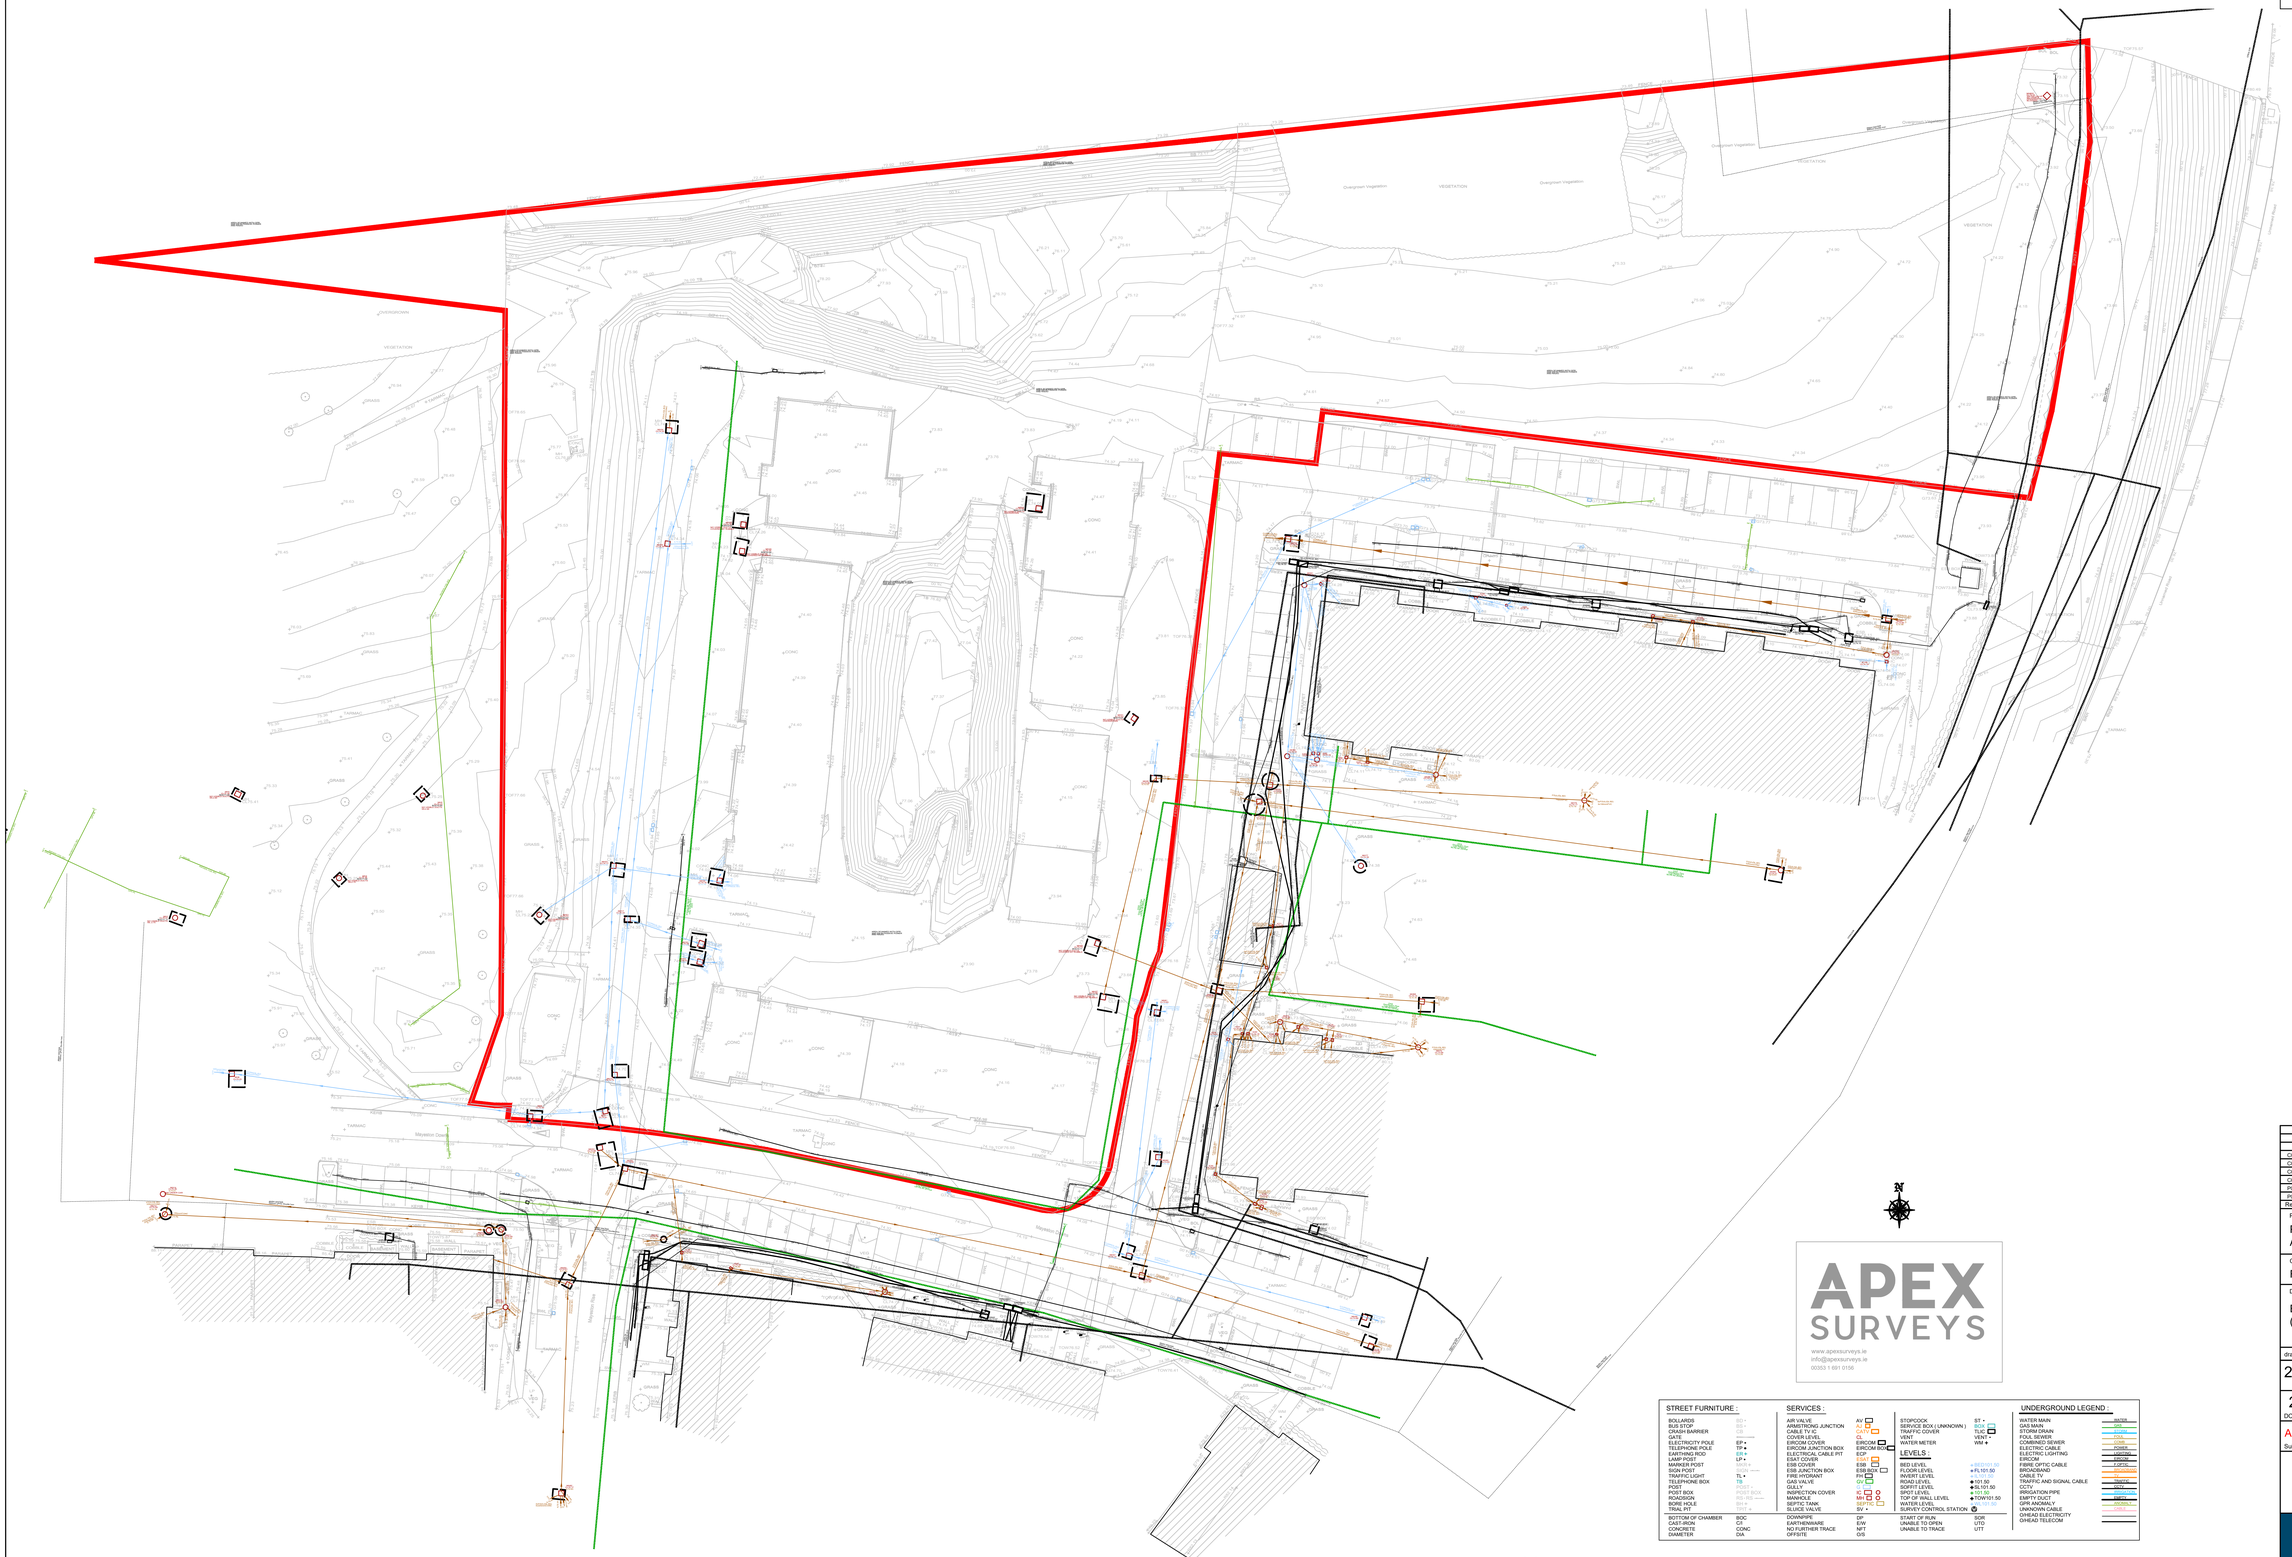

STREET FURNITURE :

BOLLARDS	BO •
BUS STOP	BS •
CRASH BARRIER	CB
GATE	GT
ELECTRICITY POLE	EP •
TELEPHONE POLE	TP •
EARTHING ROD	ER •
LAMP POST	LP •
MARKER POST	MRKR •
SIGN POST	SIGN •
TRAFFIC LIGHT	TL •
TELEPHONE BOX	TB
POST	POST •
POST BOX	POST BOX
POSSIDON	POSS •
BORE HOLE	BH •
TRIAL PIT	TP •

SERVICES :

AIR VALVE	AV
ARMSTRONG JUNCTION	AJ
CABLE TV IC	CATV
COVER LEVEL	CL
EIRCOM MANHOLE	EIRCOM
EIRCOM JUNCTION BOX	EIRCOM BOX
ELECTRICAL CABLE PIT	ECP
ESAT COVER	ESAT
ESB COVER	ESB
ESB JUNCTION BOX	ESB BOX
FIRE HYDRANT	FH
GAS VALVE	GV
GULLY	GY
INSPECTION COVER	IC
MANHOLE	MH
SEPTIC TANK	SEPTIC
SLUICE VALVE	SV •

STOPCOCK	ST •
SERVICE BOX (UNKNOWN)	BOX
TRAFFIC COVER	TCC
VENT	VENT •
WATER METER	WM •

LEVELS :

BED LEVEL	● BED101.00
CROWN LEVEL	● FL101.50
INVERT LEVEL	● FL101.00
ROAD LEVEL	◆ 101.50
SOFFIT LEVEL	◆ SL101.50
TOP OF WALL LEVEL	◆ TOW101.50
WATER LEVEL	◆ WAT101.50
SURVEY CONTROL STATION	

BOTTOM OF CHAMBER	BOC
CAST-IRON	CI
CONCRETE	CONC
DIAMETER	DIA
DOWNPIPE	DP
EARTHENWARE	EW
NO FURTHER TRACE	NFT
OFFSITE	O/S
START OF RUN	SOR
UNABLE TO OPEN	UTO
UNABLE TO TRACE	UTT

UNDERGROUND LEGEND :

WATER MAIN	WATER
GAS MAIN	GAS
STORM DRAIN	STORM
FOUL SEWER	FOUL
COMBINED SEWER	COMB
ELECTRIC CABLE	POWER
ELECTRIC LIGHTING	LIGHTING
EIRCOM	EIRCOM
FIBRE OPTIC CABLE	F.OPTIC
TELEPHONE	TEL
CABLE TV	CATV
TRAFFIC AND SIGNAL CABLE	TRAFFIC
CCTV	CCTV
DUCT/DUCTION PIPE	DUCT
EMPTY DUCT	EMPTY
GPR ANOMALY	GPR ANOMALY
UNKNOWN CABLE	UNKNOWN
OHNEAD ELECTRICITY	OHNEAD ELECTRICITY
OHNEAD TELECOM	OHNEAD TELECOM

Rev	Date	Amendments	by	chkd
C04	26.10.23	BLUE LINE REMOVED	AG	AD
C03	21.09.23	AP - PLANNING	AG	AD
C02	03.04.23	BLUE LINE ADDED	AG	AD
C01	08.03.23	AT - TENDER	AG	AD
P02	29.08.22	RED LINE REVISED	AG	AD
P01	24.08.22	ISSUED FOR PLANNING	AG	AD

PROJECT

PROPOSED HOUSING DEVELOPMENT AT MAYESTON, POPPINTREE, DUBLIN 11

CLIENT

FINGAL COUNTY COUNCIL

DRAWING TITLE

EXISTING UTILITY SURVEY (NON-EDITED)

drawn by: AG	date: 17.08.22	scale: 1:250 @ A0	chk: AD

21208 - DOW - 00 - XX-DR-C

Project	Originator	Volume	Level	Type	Role
21208	5001			C04	
DOW Project No.	drg. no.		rev.		

AP - PLANNING

Suitability Status: Code - Description

Cashel Business Centre,
Cashel Road, Kimmage, Dublin 12
T 01 4901611
E admin@downesassociates.ie
www.downesassociates.ie

Downes associates
Consulting Structural & Civil Engineers

APEX SURVEYS
www.apexsurveys.ie
info@apexsurveys.ie
00353 1 691 0156

THIS DRAWING IS COPYRIGHT